

GROUND FLOOR EMERGENCY DOORS AND FIRE EXIT LAYOUT

SCALE : NTS

CONTRACTOR:



ELECTRICAL • INDUSTRIAL • ELECTRONICS • COMMUNICATIONS
810 AURORA BLVD., COR. YALE ST., CUBAO, QUEZON CITY TEL NOS. 02-9128881/02-9129871

ENGINEER:

OWNER:

**DEPARTMENT OF
FOREIGN AFFAIRS**
OFFICE OF CONSULAR AFFAIRS
ASEANA, MACAPAGAL AVE., PASAY CITY



PROJECT TITLE :

**SUPPLY & INSTALLATION
OF FIRE DETECTION AND
ALARM SYSTEM**

SHEET NO. **E-1**

SHEET CONTENT:
AS-BUILT PLAN

DRAWN BY: **mike**

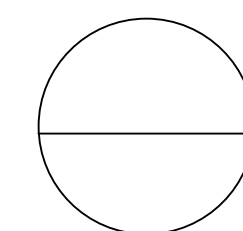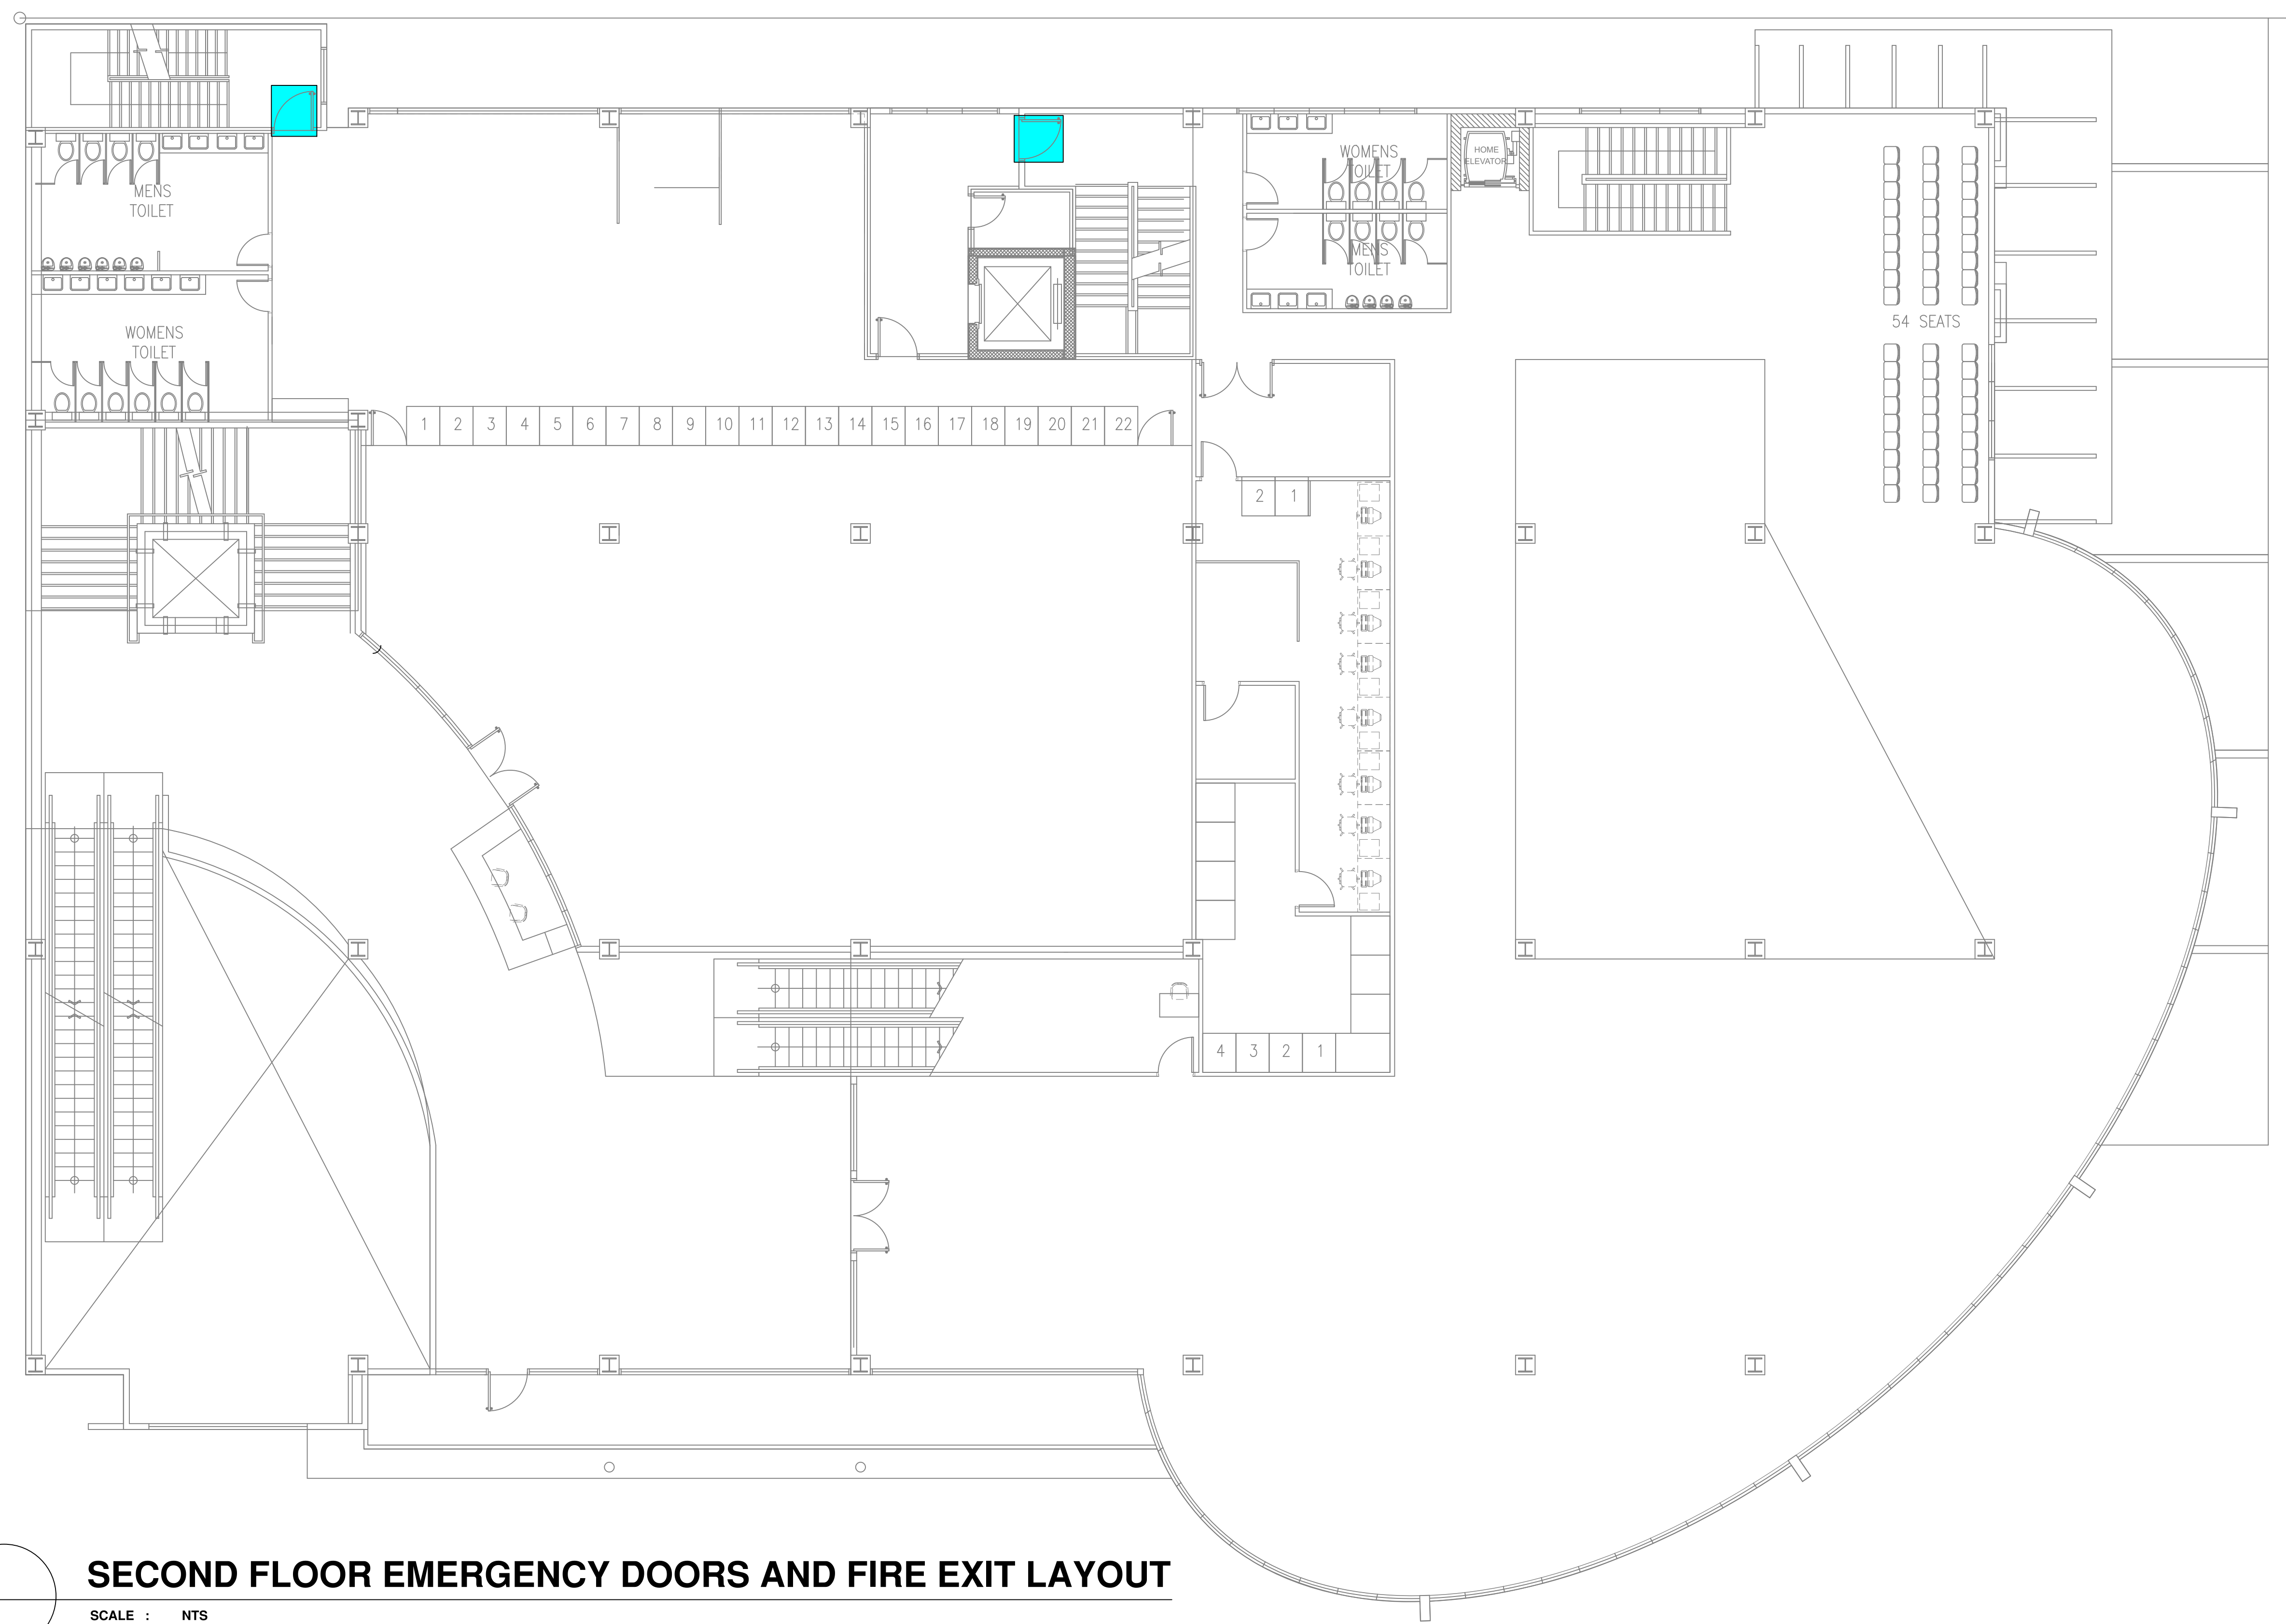

SECOND FLOOR EMERGENCY DOORS AND FIRE EXIT LAYOUT

SCALE : NTS

CONTRACTOR:



ELECTRICAL • INDUSTRIAL • ELECTRONICS • COMMUNICATIONS
810 AURORA BLVD., COR. YALE ST., CUBAO, QUEZON CITY TEL NOS. 02-9128881/02-9129871

ENGINEER:

OWNER:

**DEPARTMENT OF
FOREIGN AFFAIRS
OFFICE OF CONSULAR AFFAIRS
ASEANA, MACAPAGAL AVE., PASAY CITY**


PROJECT TITLE :


**SUPPLY & INSTALLATION
OF FIRE DETECTION AND
ALARM SYSTEM**

SHEET NO. **E-2**

SHEET CONTENT:
AS-BUILT PLAN

DRAWN BY:

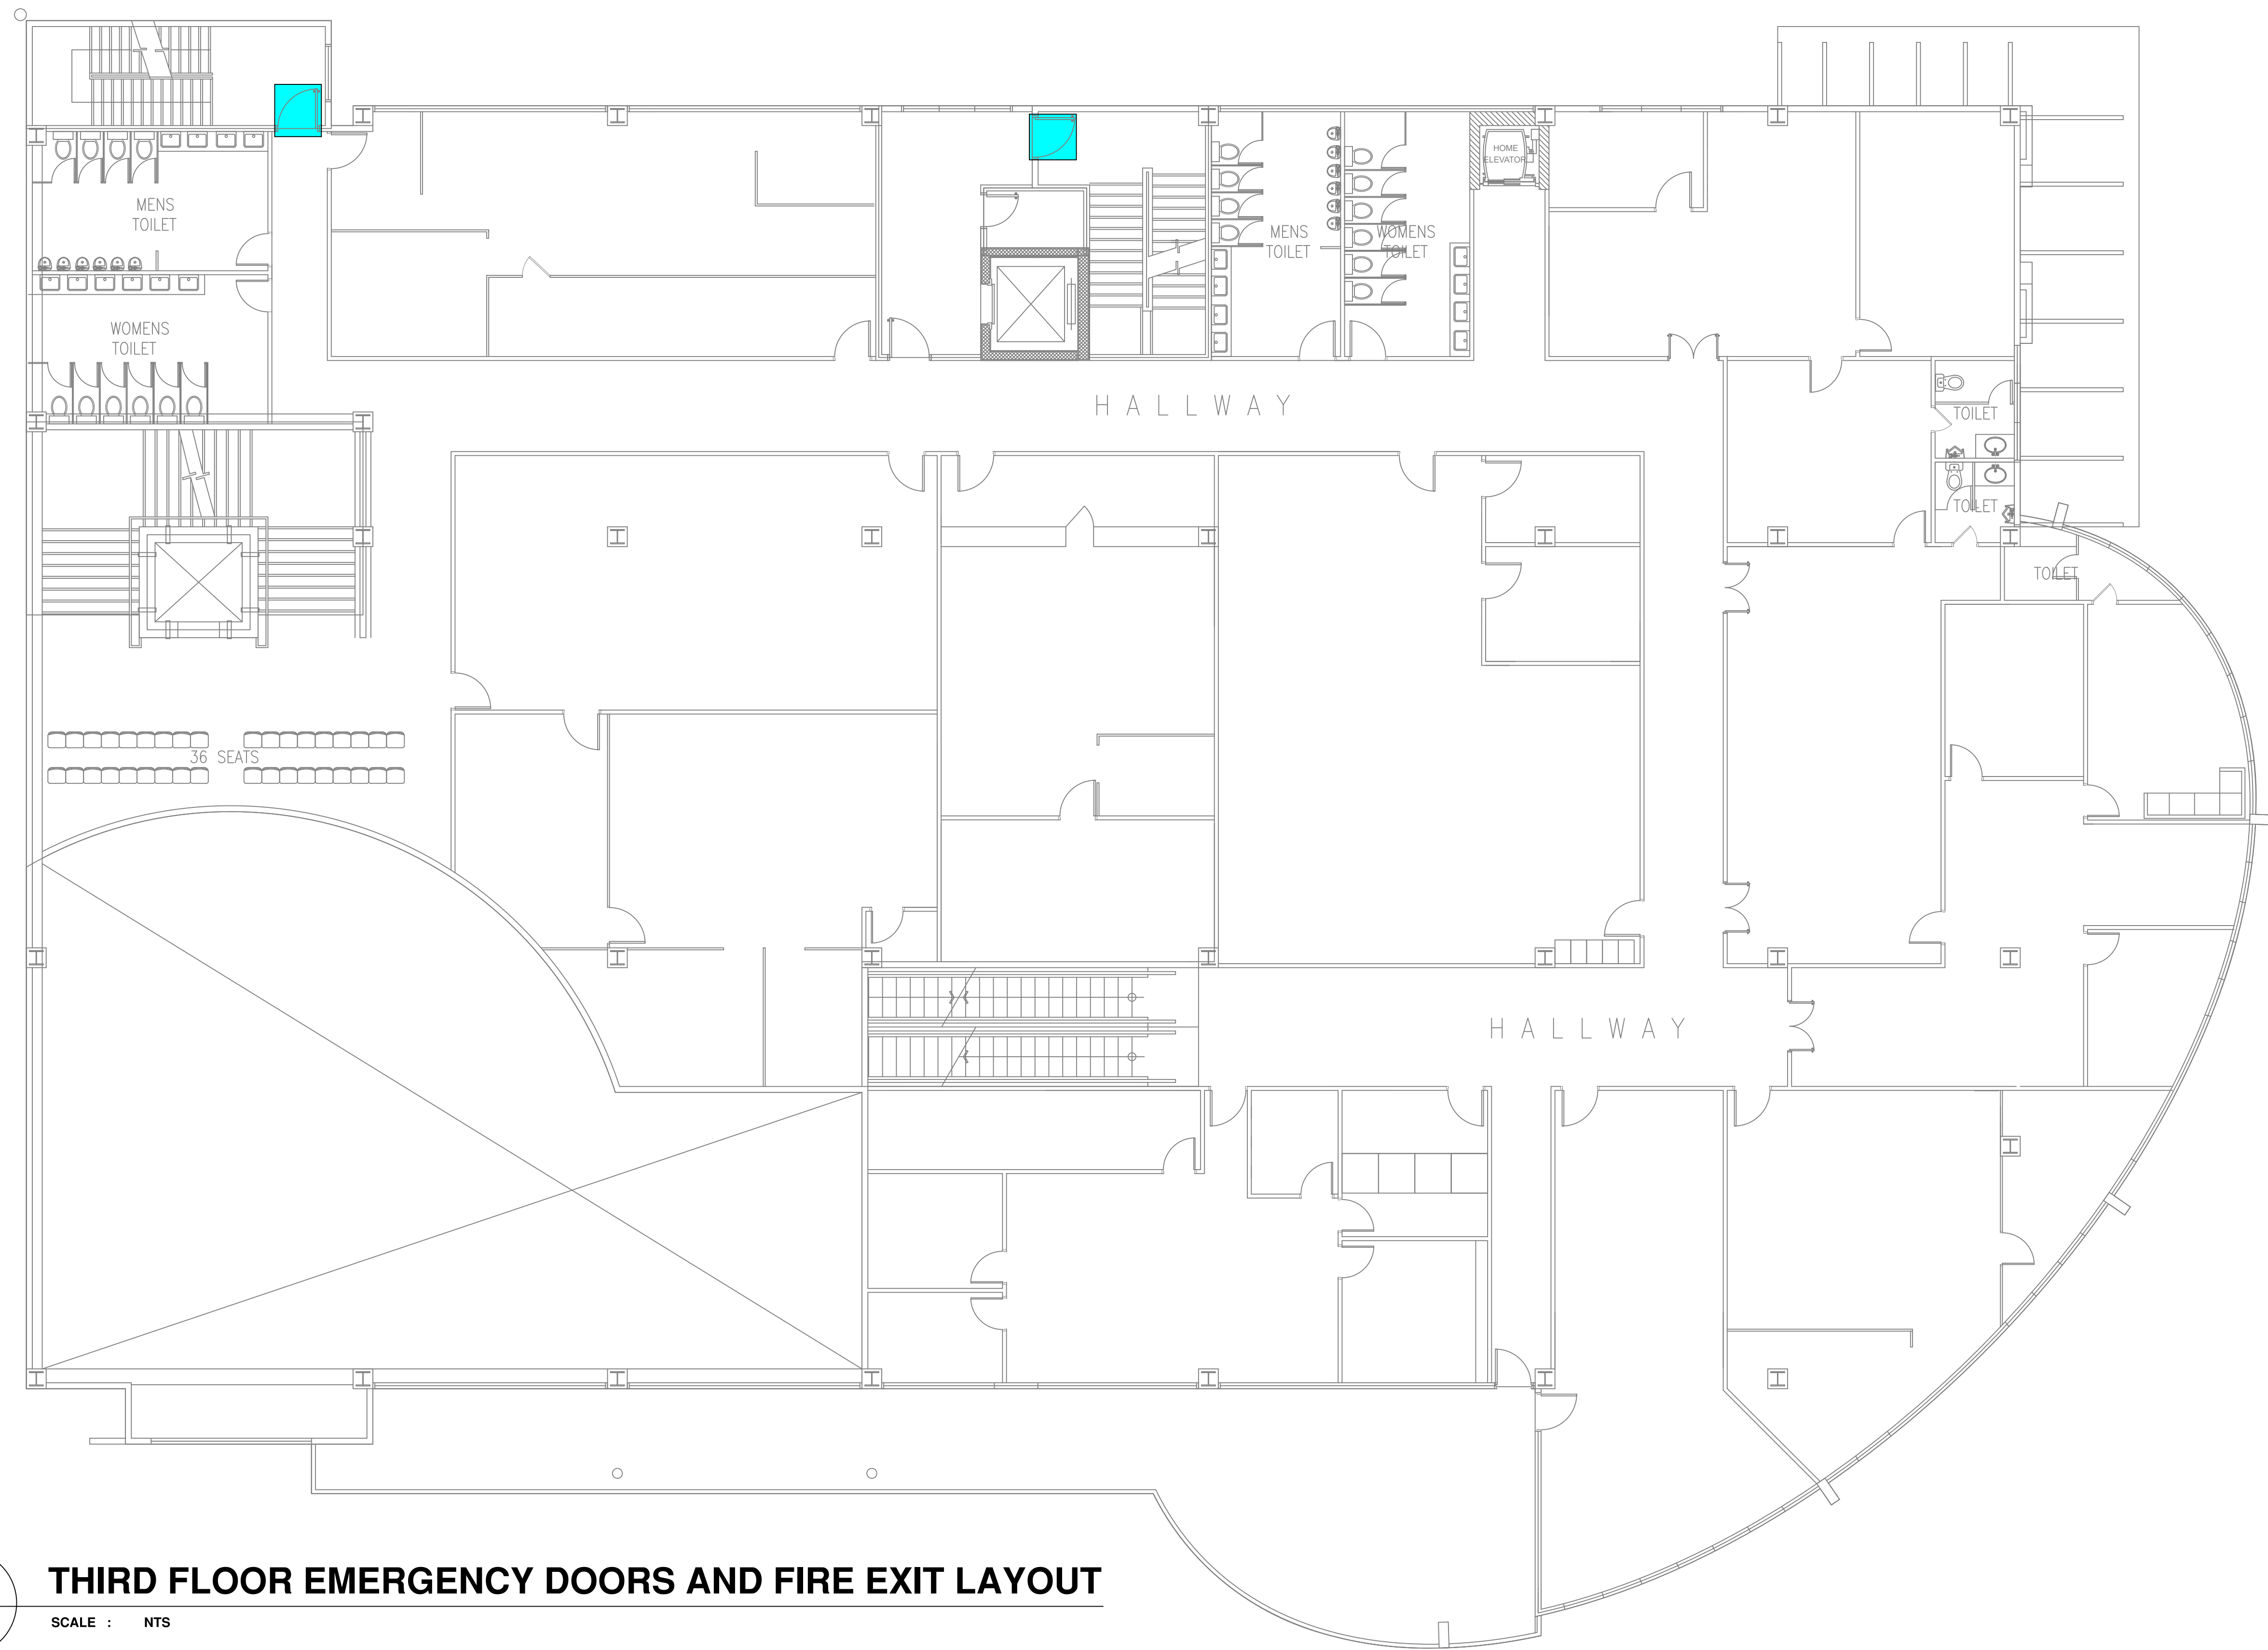

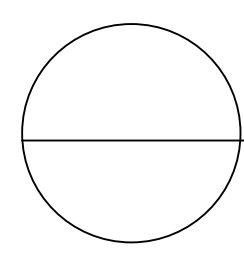
THIRD FLOOR EMERGENCY DOORS AND FIRE EXIT LAYOUT
 SCALE : NTS

CONTRACTOR:



ELECTRICAL • INDUSTRIAL • ELECTRONICS • COMMUNICATIONS
 810 AURORA BLVD., COR. YALE ST., CUBAO, QUEZON CITY TEL NOS. 02-9128881/02-9129871

ENGINEER:

OWNER:

**DEPARTMENT OF
 FOREIGN AFFAIRS**
 OFFICE OF CONSULAR AFFAIRS
 ASEANA, MACAPAGAL AVE., PASAY CITY


PROJECT TITLE :

**SUPPLY & INSTALLATION
 OF FIRE DETECTION AND
 ALARM SYSTEM**

SHEET NO. **E-3**

SHEET CONTENT:
AS-BUILT PLAN

DRAWN BY:

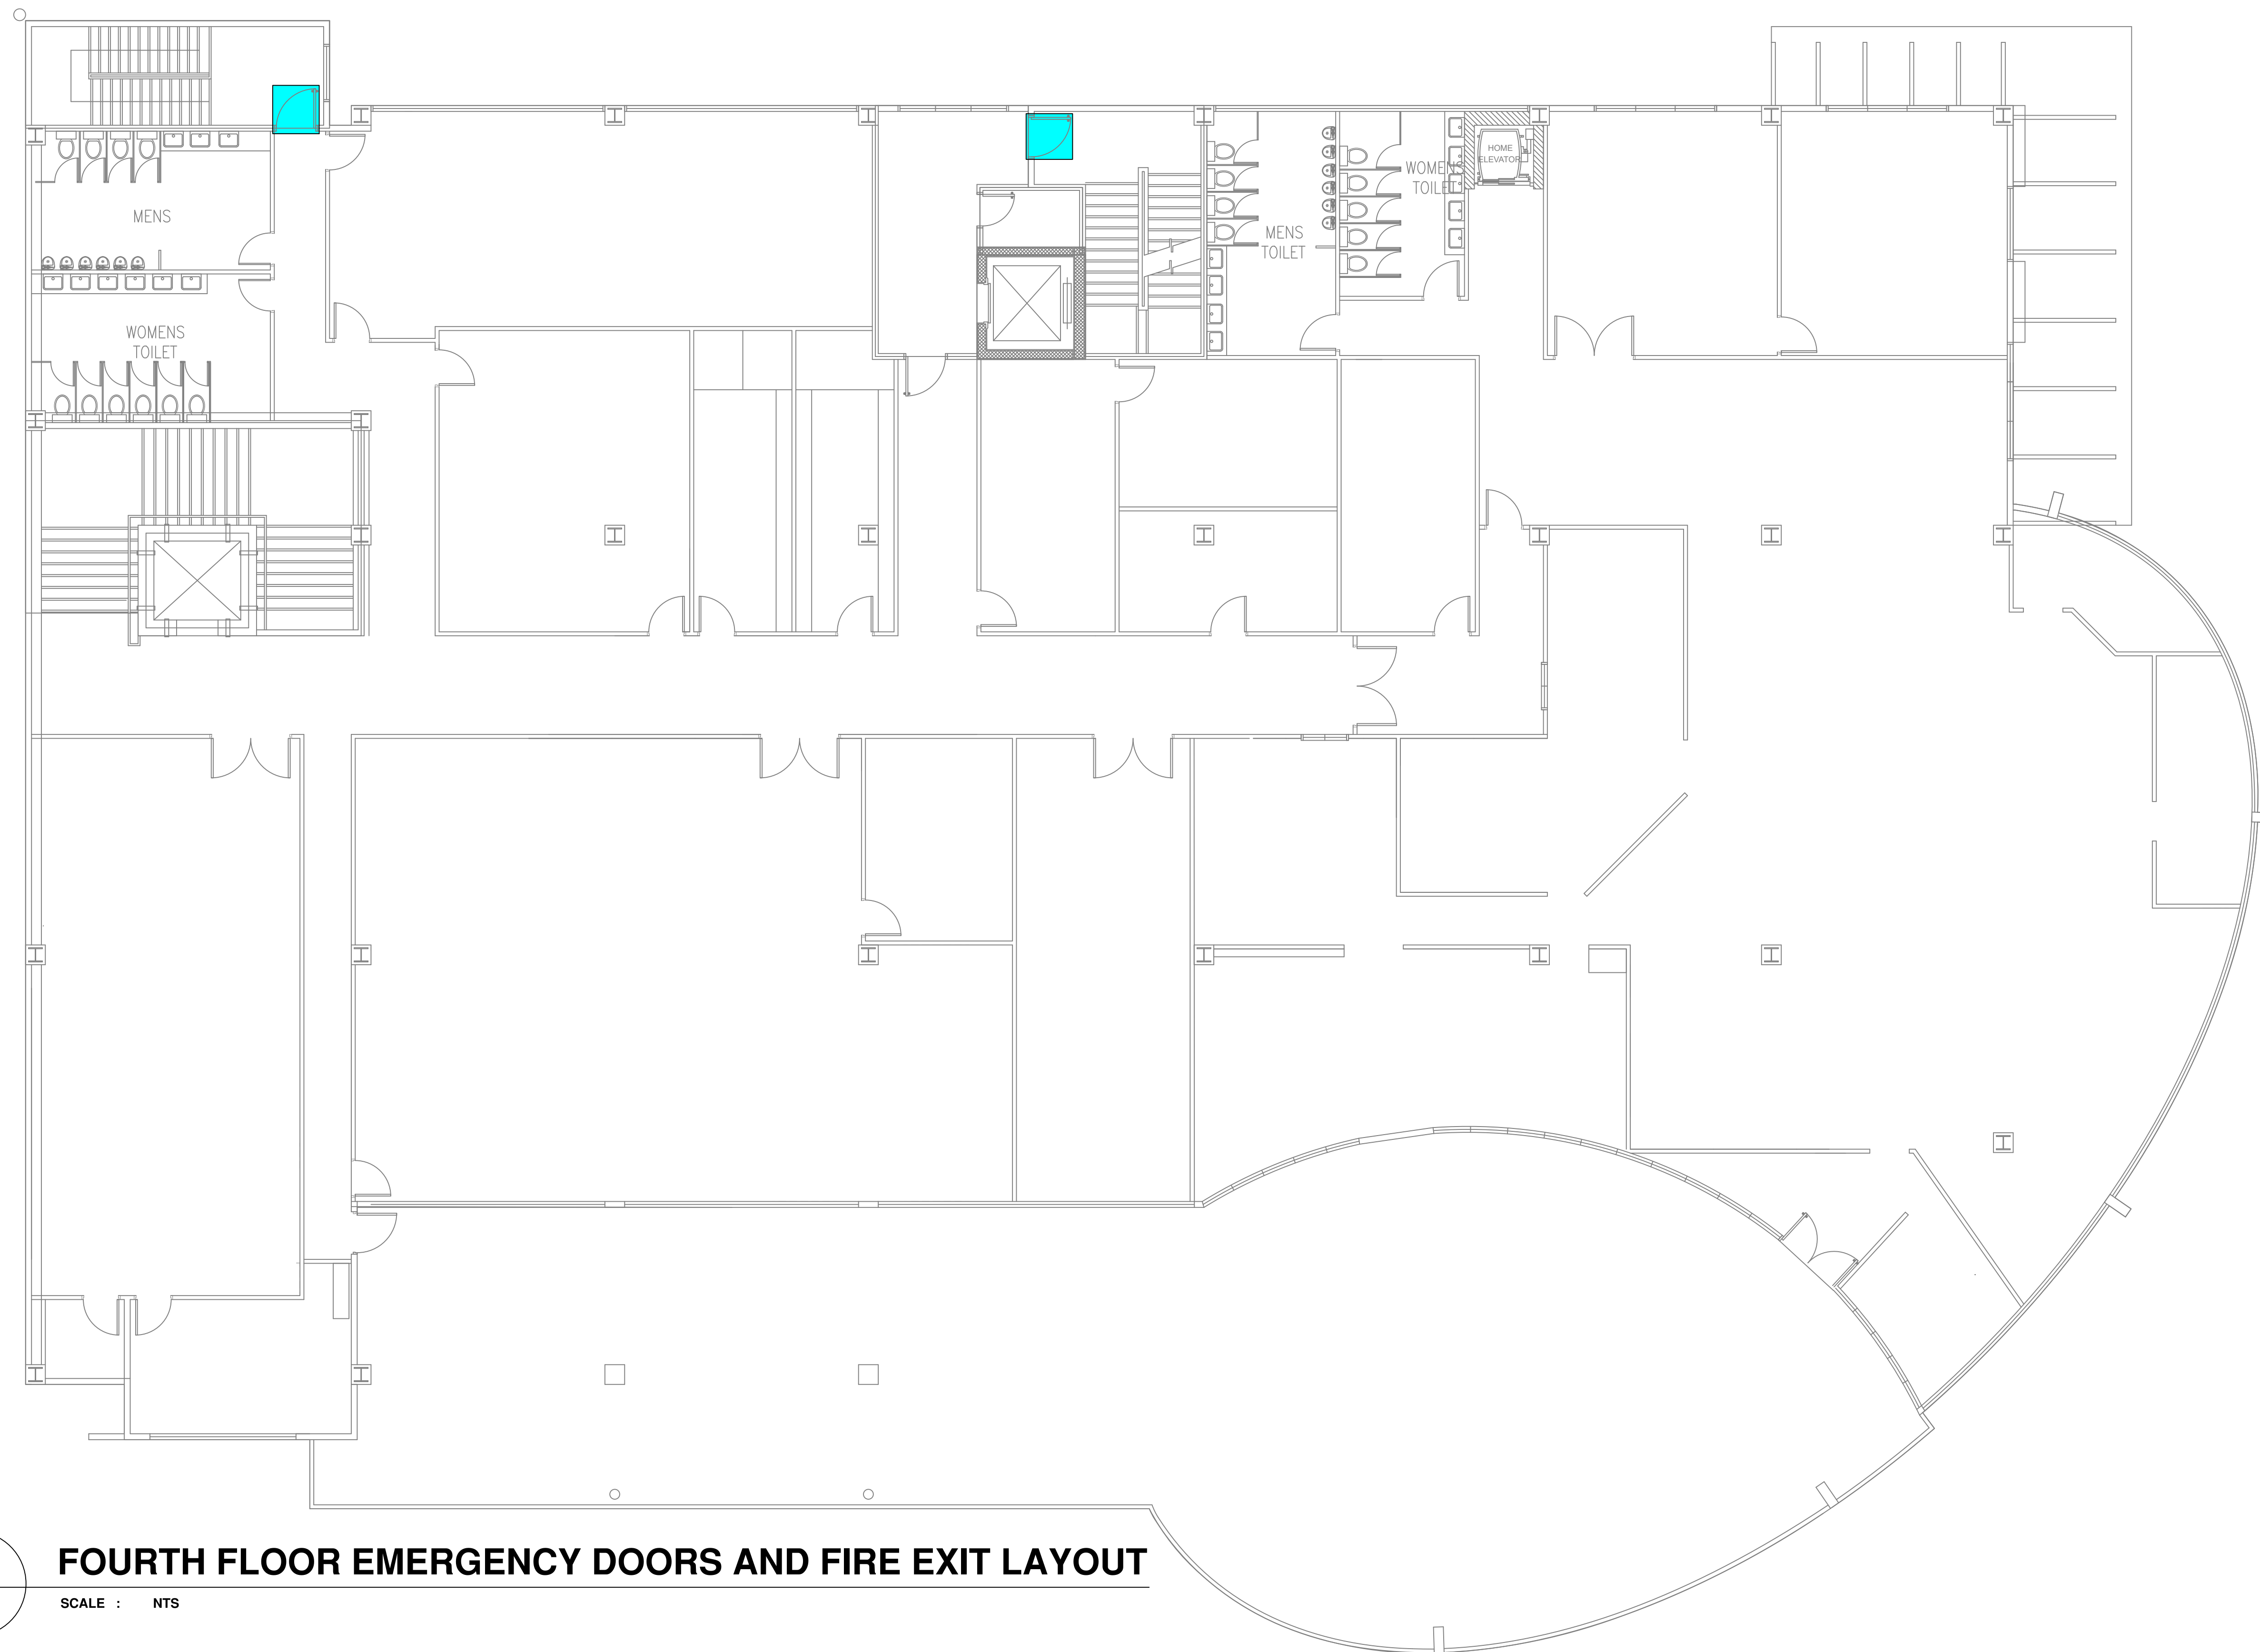


FOURTH FLOOR EMERGENCY DOORS AND FIRE EXIT LAYOUT
 SCALE : NTS

CONTRACTOR:

ELECTRICAL • INDUSTRIAL • ELECTRONICS • COMMUNICATIONS
810 AURORA BLVD., COR. YALE ST., CUBAO, QUEZON CITY TEL NOS. 02-9128881/02-9129871

ENGINEER:

OWNER:
DEPARTMENT OF FOREIGN AFFAIRS
OFFICE OF CONSULAR AFFAIRS
ASEANA, MACAPAGAL AVE., PASAY CITY

PROJECT TITLE :
SUPPLY & INSTALLATION OF FIRE DETECTION AND ALARM SYSTEM

SHEET NO. E-2
SHEET CONTENT:
AS-BUILT PLAN
DRAWN BY: